AS BUILT SITE

THE POTTER REALTY CO., LLC, LANDS

BEING ALL OF THAT CERTAIN LOT OR TRACT OF LAND LYING IN THE HARRISON MAGISTERIAL DISTRICT, WASHINGTON COUNTY, VA., AND MORE PARTICULARLY DESCRIBED IN INSTRUMENT NO. 8486.

283,663 SQ.FT.
6.51 AC±

ZONED M3

TAX MAP NO. 86-A-27

FINISHED CONTOUR INTERVAL = 2

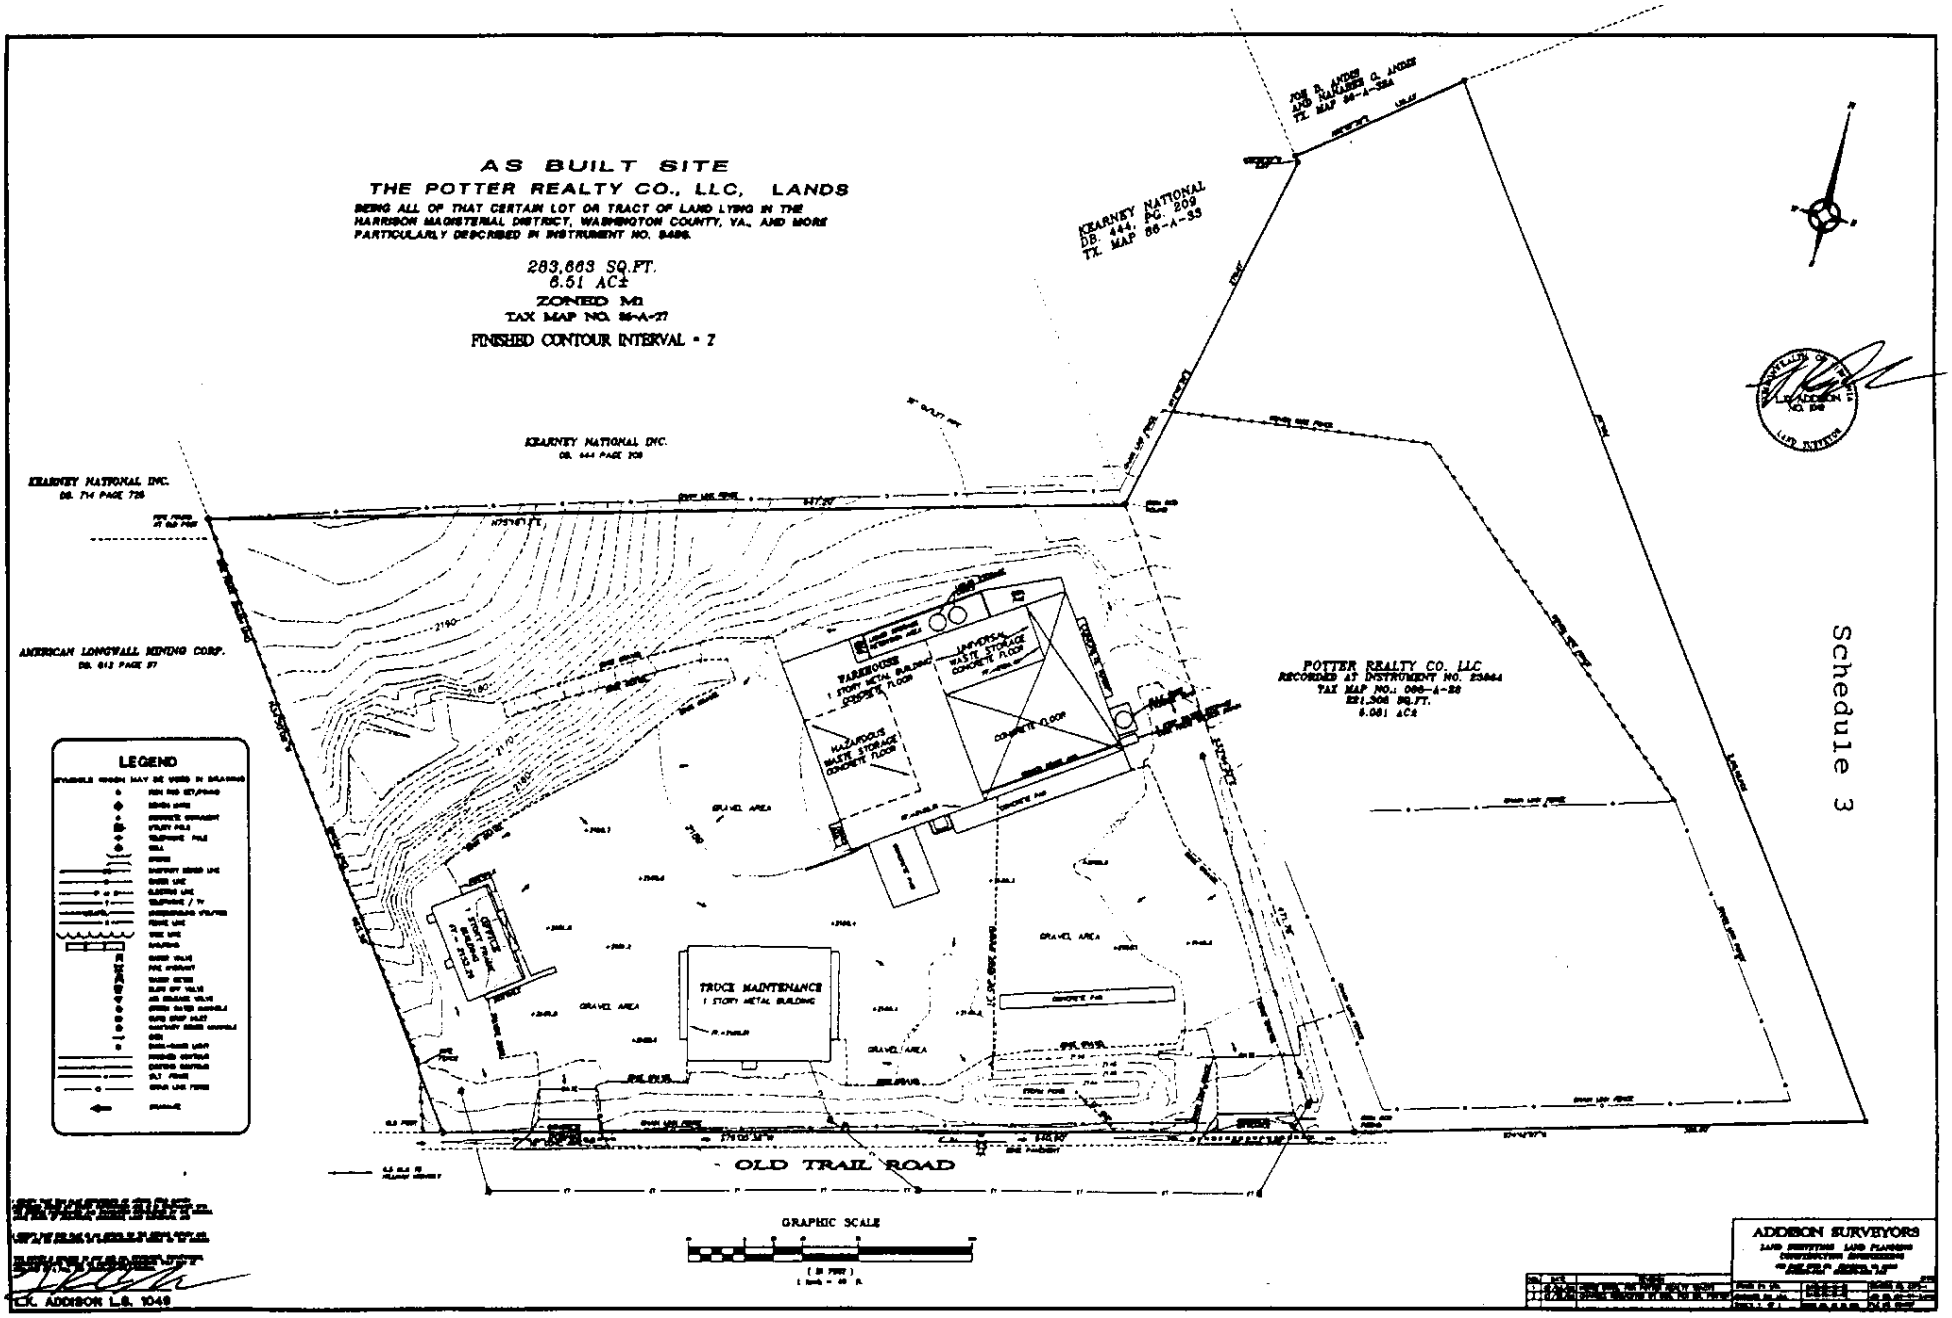

Schedule 3

C.K. ADDISON L.S. 1049

ADDISON SURVEYORS
LAND SURVEYING LAND PLANNING
CONSTRUCTION ENGINEERING